

STATE OF UTAH
DEPARTMENT OF NATURAL RESOURCES
DIVISION OF OIL, GAS AND MINING
 1594 West North Temple - Suite 1210
 Box 145801
 Salt Lake City, Utah 84114-5801
 Telephone: (801) 538-5291
 Fax: (801) 359-3940

RECEIVED
 JAN 30 2015
 DIV. OF OIL, GAS & MINING

LARGE MINING OPERATIONS PROGRESS REPORT
January 1, 2014 to December 31, 2014

The information required in this form is based on provisions of the Mined Land Reclamation Act, Title 40-8, and the R647 rules under the Utah Minerals Regulatory Program.

1. Mine Permit Number: M/051/0013
2. Mine Name: Center Creek Quarry
3. Name of Operator/Permittee: Geneva Rock Products, Inc.

Note: If Operator's address, company representative or phone number have changed, please provide a replacement page for the Notice of Intention together with form MR-REV available on the Division's web page at https://fs.ogm.utah.gov/pub/mines/minerals_related/forms/MR-REV.pdf.

4. Report the gross amount of ore mined and waste moved:

Gross Ore Mined 2,120 Tons, or _____ yd³
 Waste Material Moved 0 Tons, or _____ yd³

5. Disturbance at the end of 2013 13.00 Acres
 New Disturbance Created during 2014 0 Acres
 Area Reclaimed and Fully Released during 2014 0 Acres
 Total Disturbed Area at the end of 2014 13.00 Acres*
 Permitted/Bonded Acreage 64.00 Acres


*The total disturbed area should not be greater than the permitted/bonded acreage

6. Briefly describe the reclamation work performed during the past year. (Submit form MR-SITE (https://fs.ogm.utah.gov/pub/mines/minerals_related/forms/MR-SITE.pdf) to apply for full or partial bond/site release). Attach additional sheets if needed.
No reclamation work has been performed during this period.

7. For large mines, include an updated map depicting surface disturbance and reclamation performed during the year (Rule R647-4-105).

I hereby certify, under penalties of law, the information provided in this report is true and correct to the best of my knowledge and belief.

Name (Typed or Print): Brent R. Sumsion
 Title of Operator: Properties and Environmental Manager
 Signature of Operator: [Signature]
 Date: Jan 30 2015

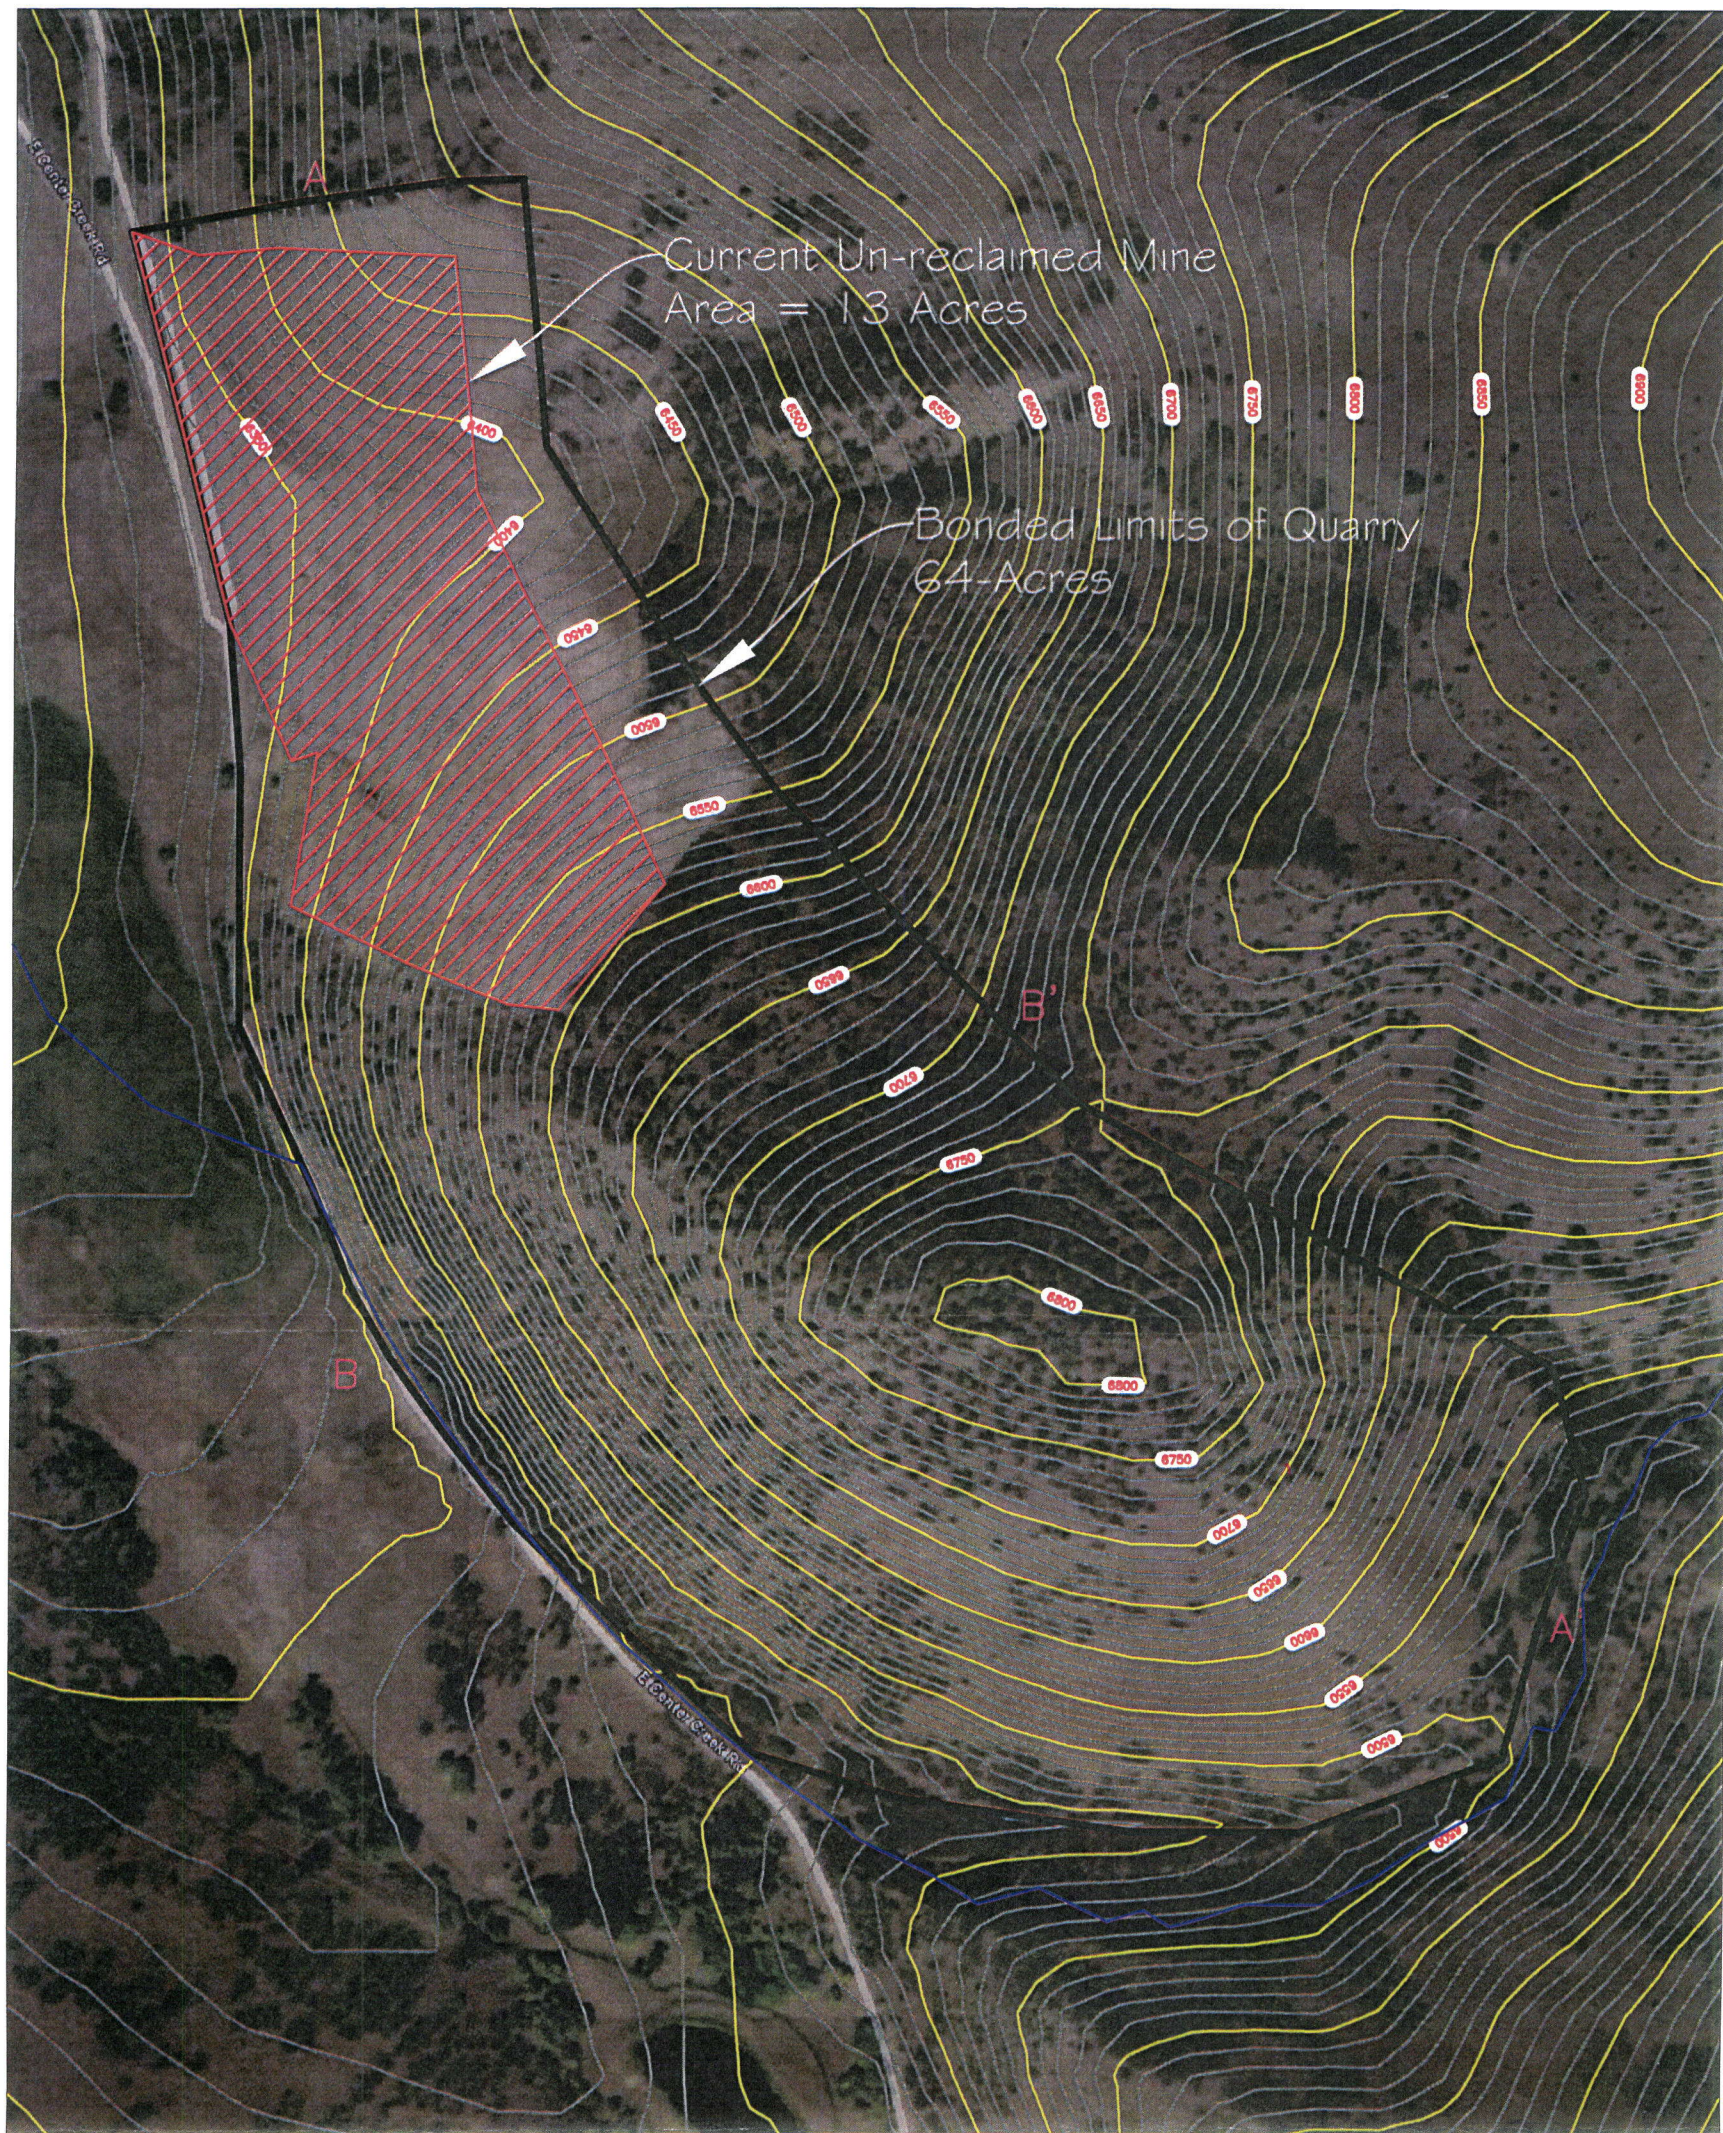

Legend

Major 50' Contour

Minor 10' Contour

Water Course

Quarry Bdy


Existing Mine Footprint



RECEIVED

JAN 30 2015

DIV OF OIL, GAS & MINING

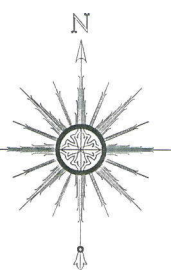

Scale 1"=300'

APPROVED

SEP 09 2011

DIV. OIL GAS & MINING

Drawn: B SUMSON
Checked: BS/CC
Approved:
Date: 12-17-09
Dwg. No.

TITLE: Center Creek Quarry
DOGM NOI
Figure 3
ISSUED FOR INTERNAL REVIEW

Revision: 00

Engineer:

NO. DATE: DESCRIPTION: BY:

Geneva Rock Center Creek Quarry
Original Contours



Geneva Rock Products, Inc.
1556 West 400 North
Orem, Utah 84057
801-765-7800